


RENOVATIONS/ALTERATIONS
TO

**THE RED TAVERN
5 PLEASANT STREET
METHUEN, MA 01844**

SUBMITTAL SET: 8-4-21



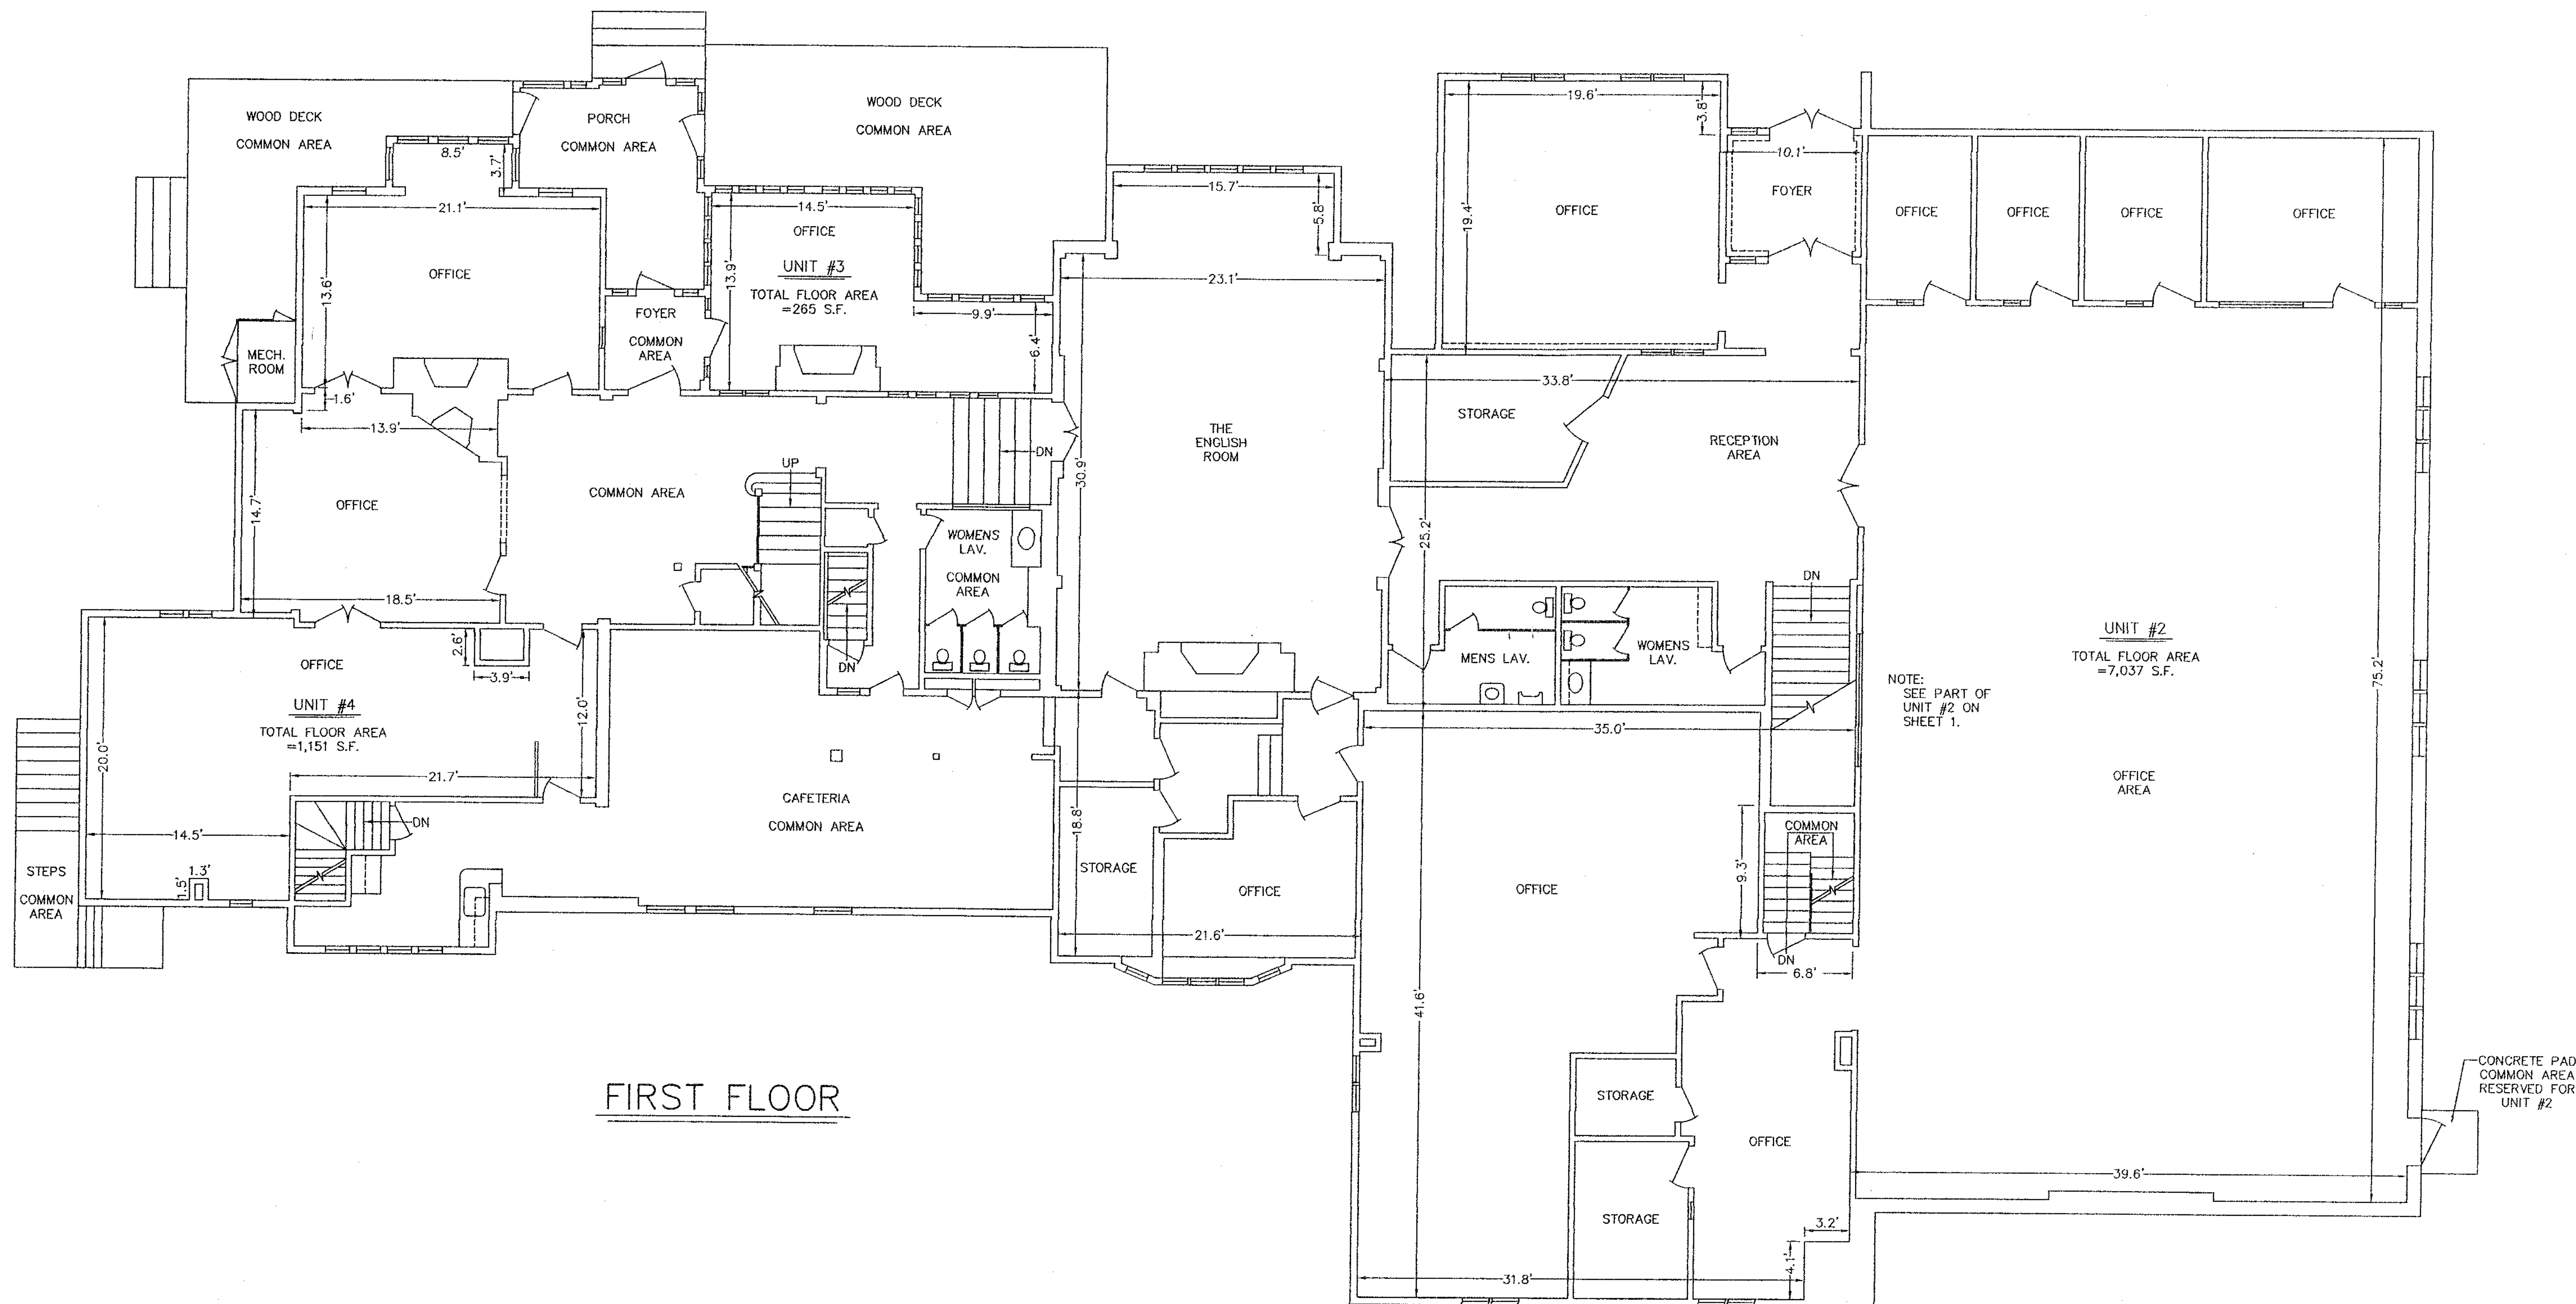

FOR REGISTRY USE ONLY

NOTE:
1.) APPROXIMATE AREA IS CALCULATED BY THE MEASUREMENT OF THE FINISHED INTERIOR WALLS. ALL AREAS AND DIMENSIONS ARE +/- AREA TOLERANCE= 15 S.F. +/-

I HEREBY CERTIFY THE FOLLOWING:

- 1.) THIS FLOOR PLAN FULLY AND ACCURATELY DEPICTS THE LOCATION, LAYOUT, UNIT NUMBERS AND DIMENSIONS OF THE UNITS SHOWN HEREON, AS BUILT. THE BUILDING IS NAMED THE RED TAVERN.
- 2.) THIS PLAN CONFORMS TO THE RULES AND REGULATIONS OF THE REGISTERS OF DEEDS OF MASSACHUSETTS.

William S. MacLeod

WILLIAM S. MacLEOD
REG. PROF. ENGINEER

CONDOMINIUM FLOOR PLAN
THE RED TAVERN CONDOMINIUM
METHUEN, MASS.

Scale: 1"=6' Date: November 14, 2006

PREPARED FOR: FIVE PLEASANT STREET, LLC

PREPARED BY:


andover consultants inc.

1 East River Place
Methuen, MA 01844


William S. MacLeod
Reg. Prof. Engineer

0 6 12 18 24 Ft.


SHEET 2 OF 3

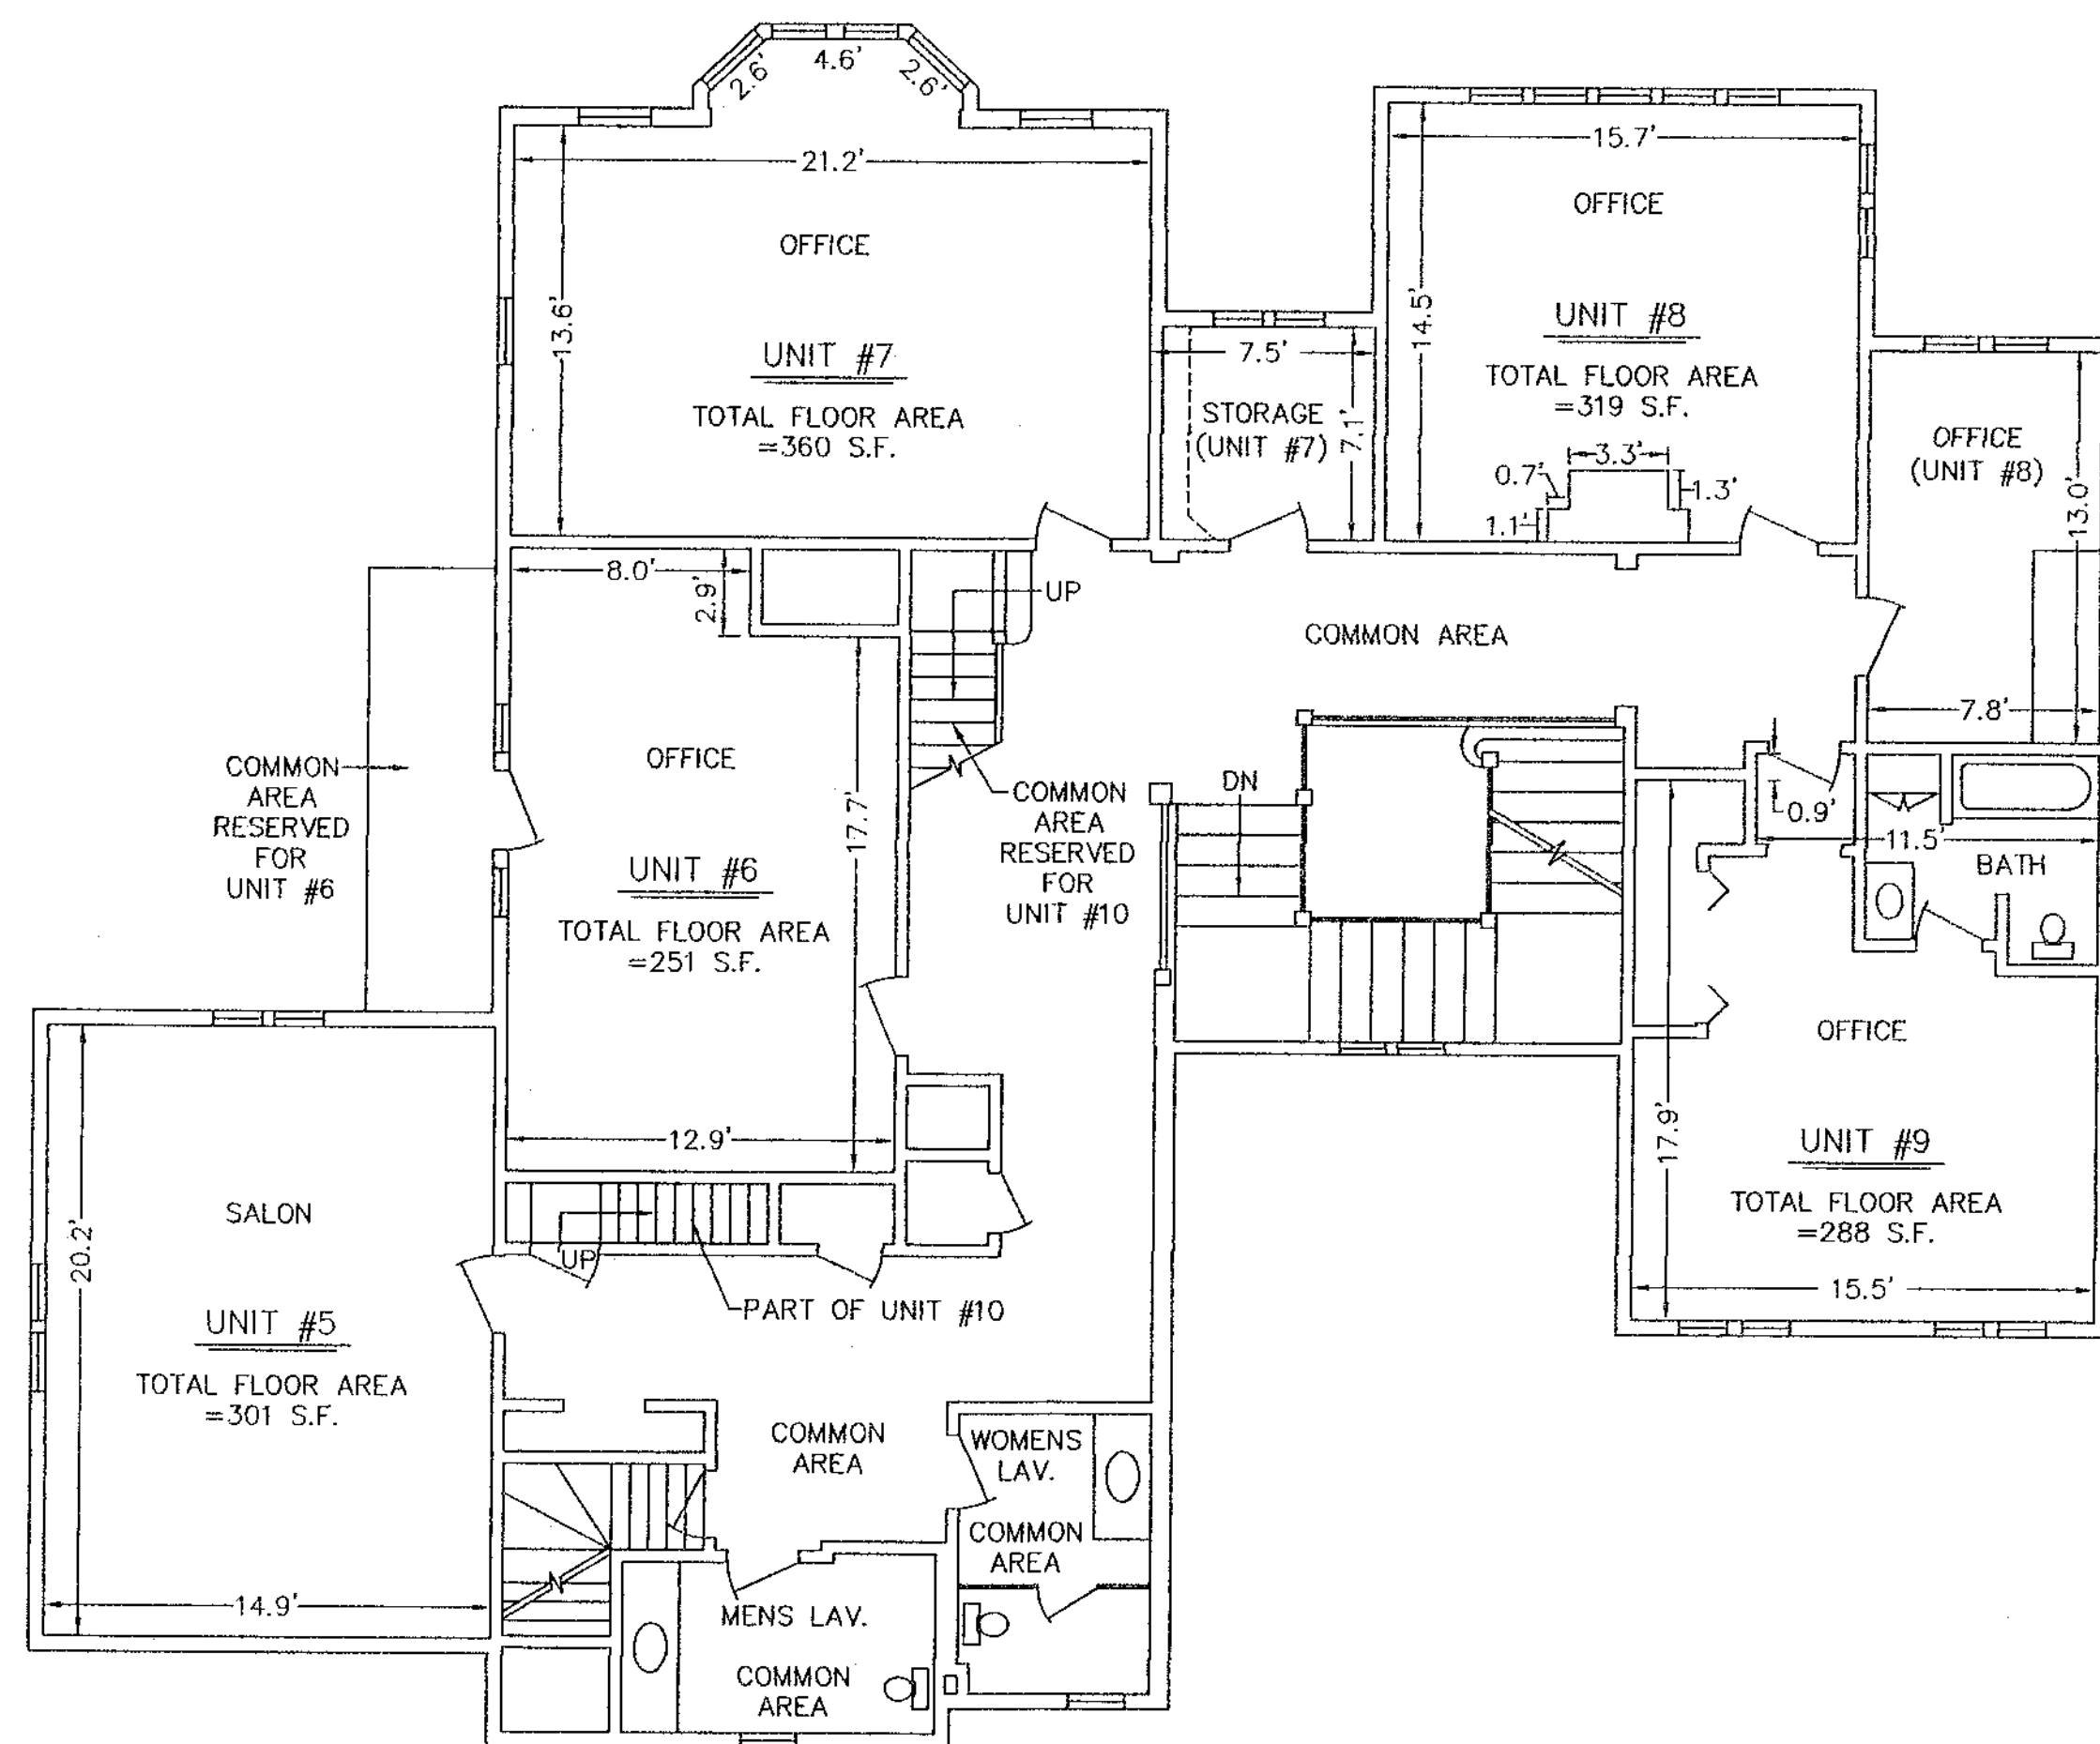


SECOND FLOOR

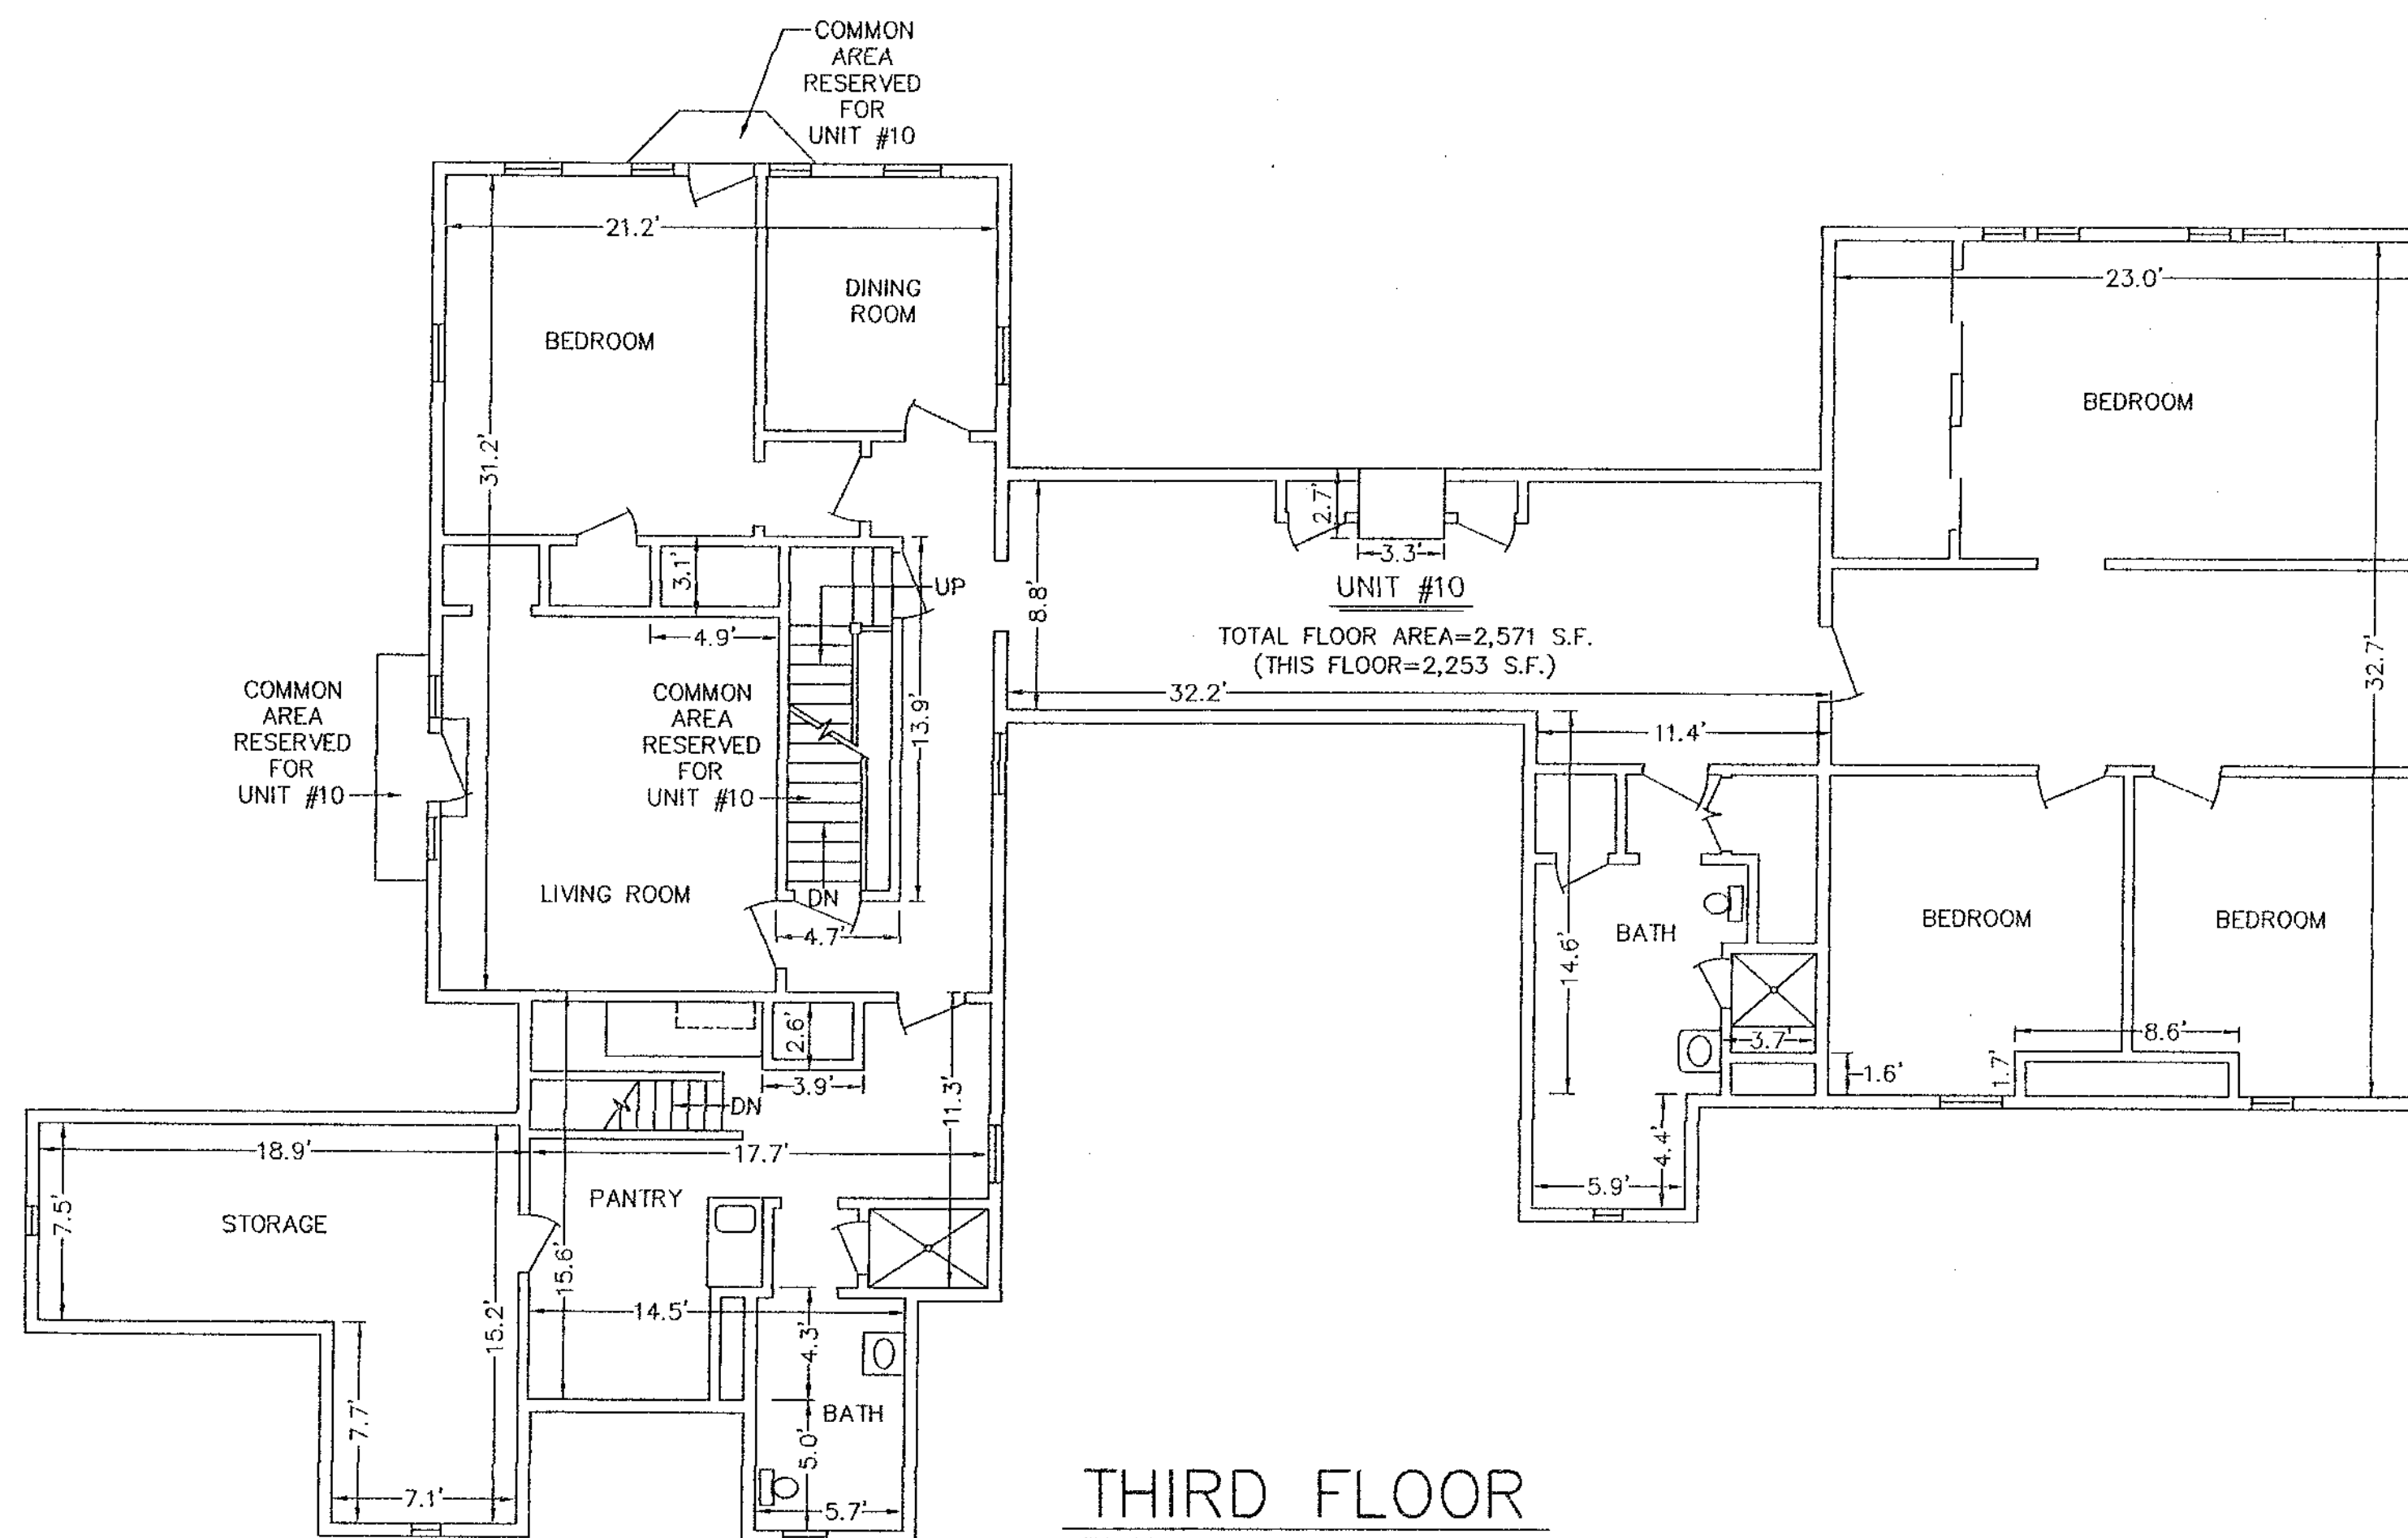

THIRD FLOOR

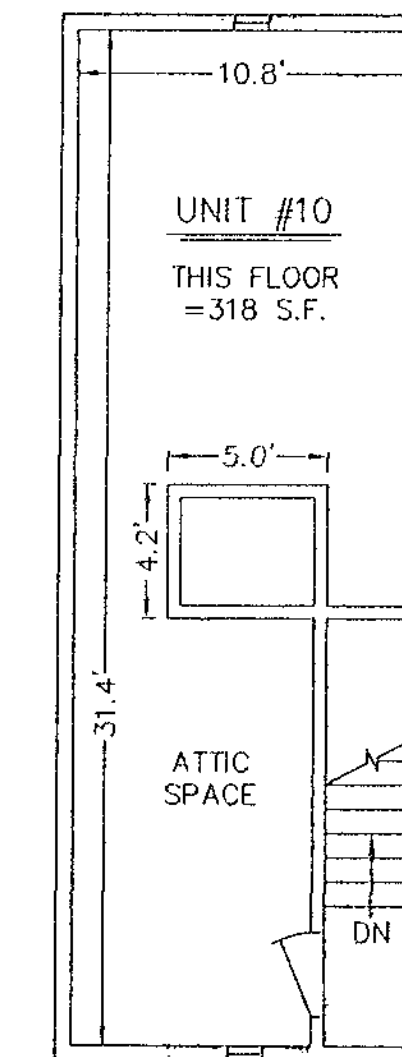

FOURTH FLOOR

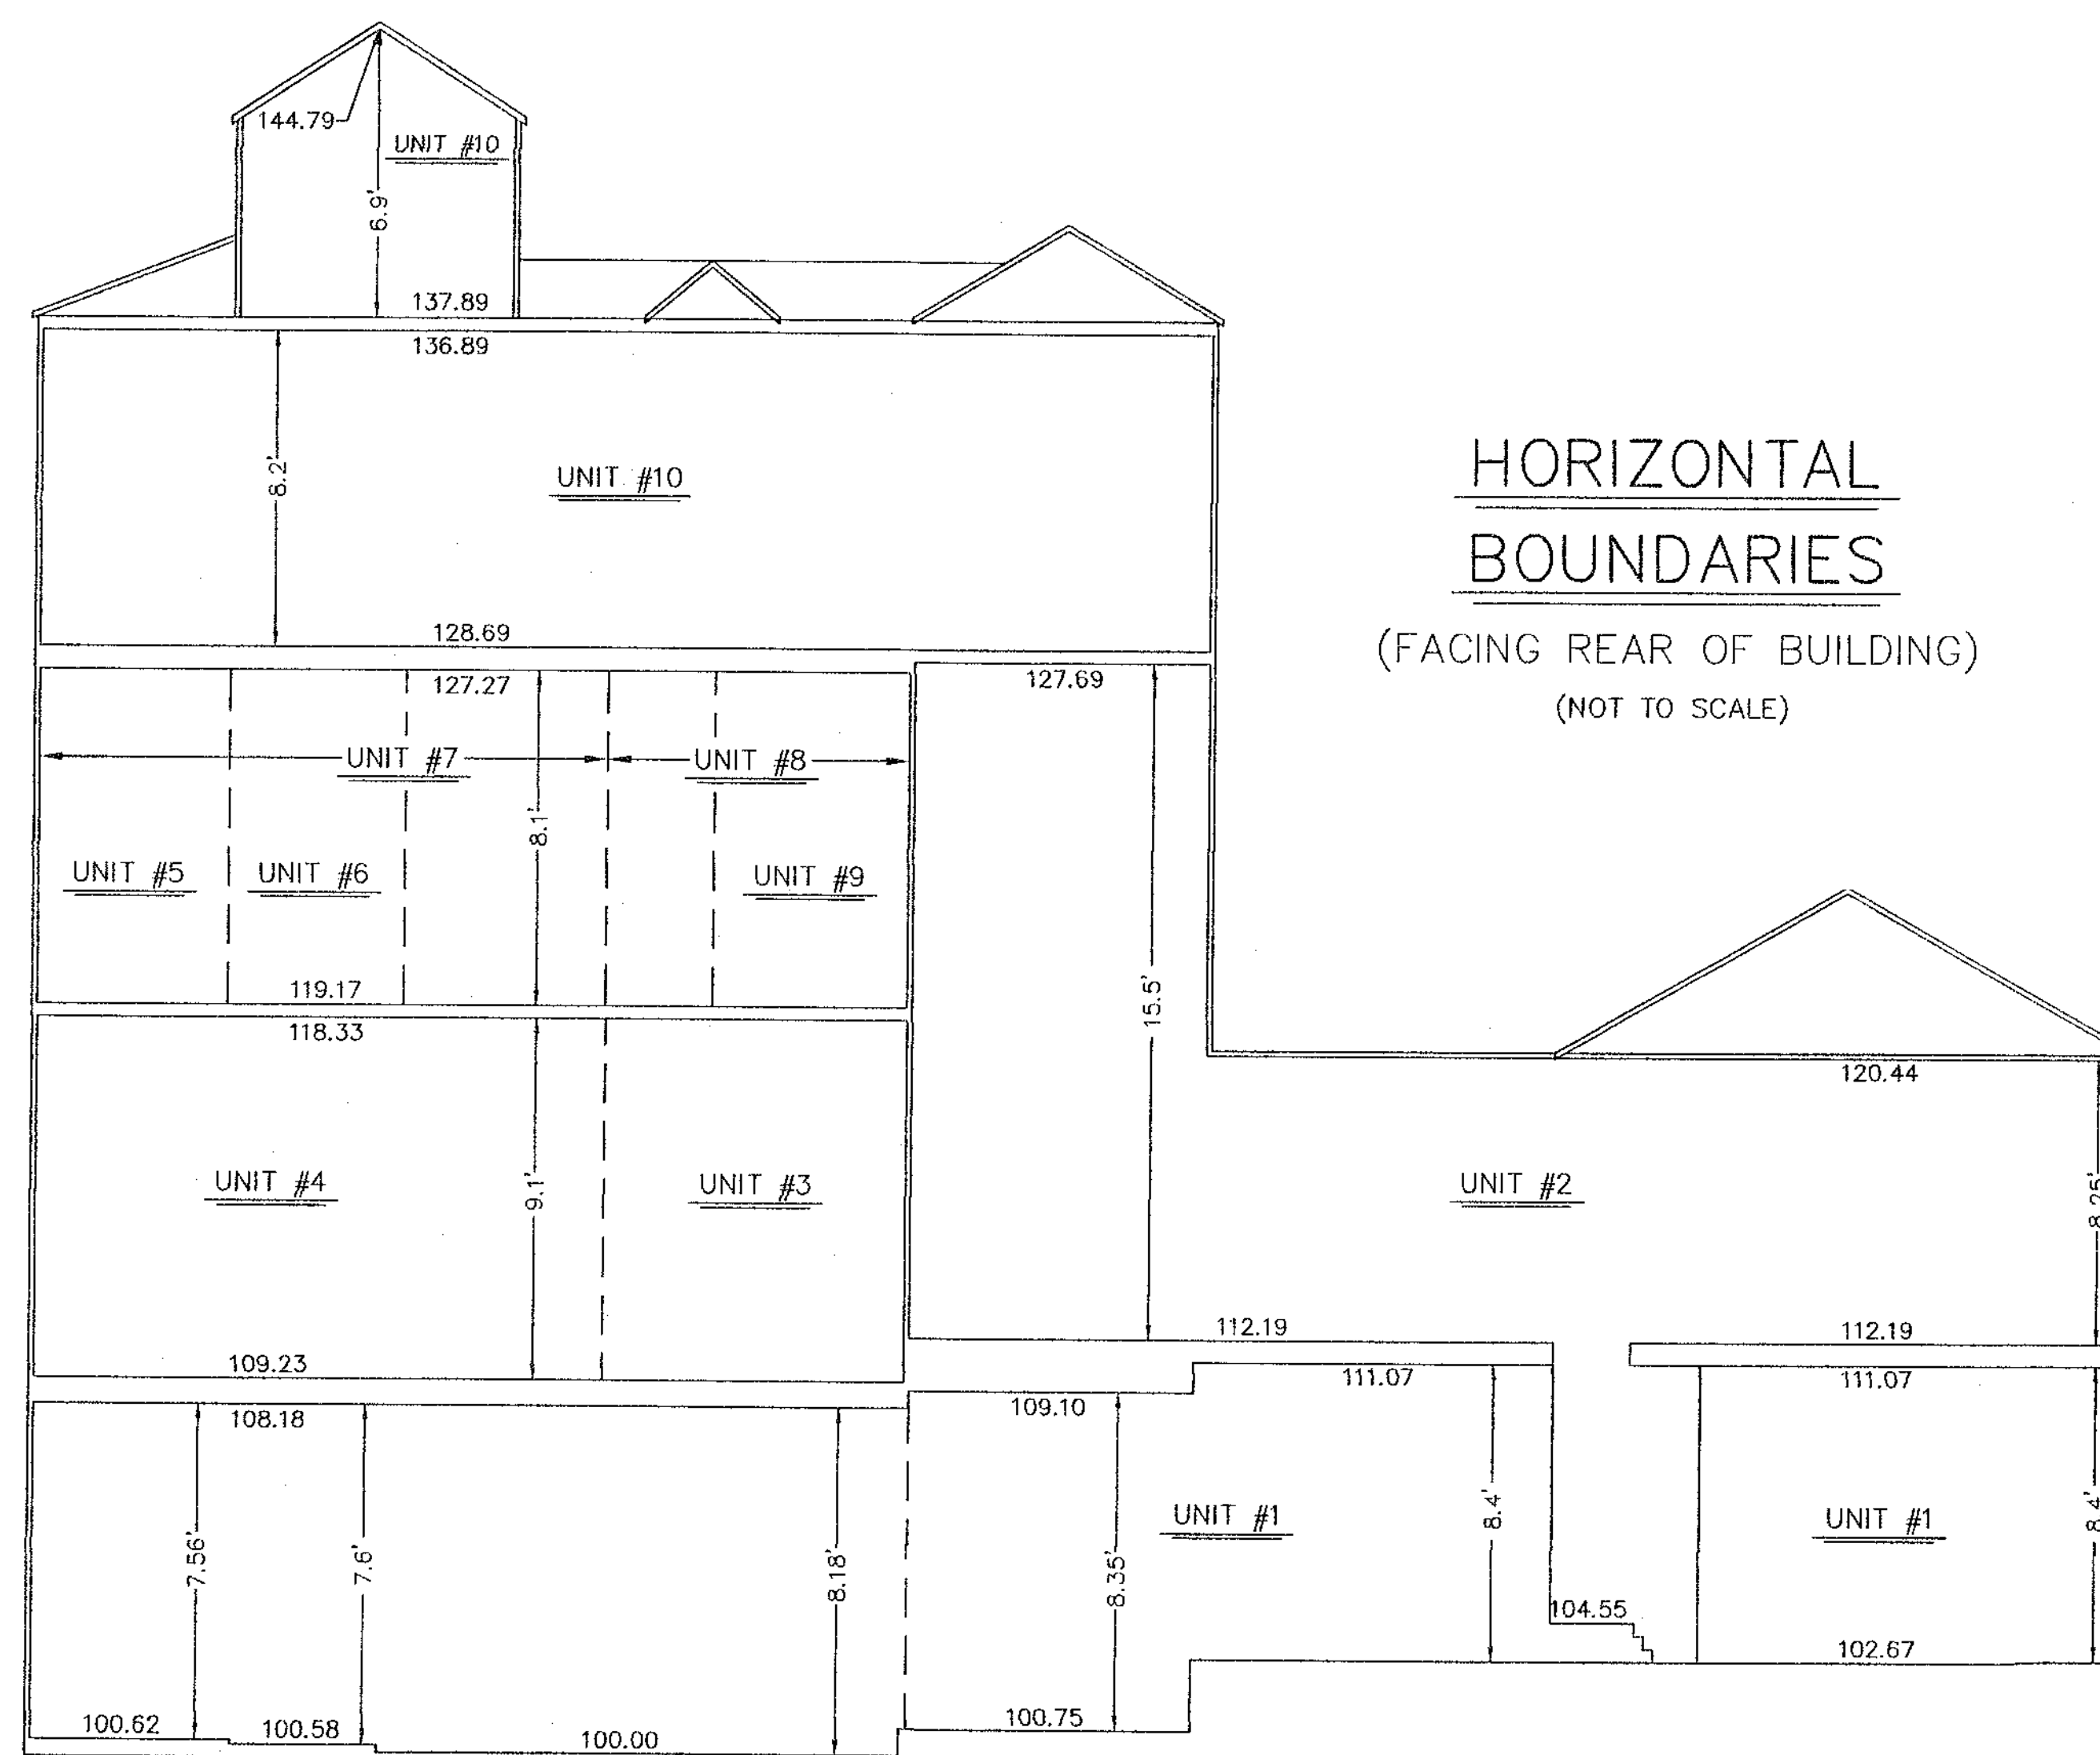

HORIZONTAL BOUNDARIES

(FACING REAR OF BUILDING)
(NOT TO SCALE)

NOTE:
1.) APPROXIMATE AREA IS CALCULATED BY THE MEASUREMENT OF THE FINISHED INTERIOR WALLS. ALL AREAS AND DIMENSIONS ARE +/- AREA TOLERANCE= 15 S.F. +/-

I HEREBY CERTIFY THE FOLLOWING:

- 1.) THIS FLOOR PLAN FULLY AND ACCURATELY DEPICTS THE LOCATION, LAYOUT, UNIT NUMBERS AND DIMENSIONS OF THE UNITS SHOWN HEREON, AS BUILT. THE BUILDING IS NAMED THE RED TAVERN.
- 2.) THIS PLAN CONFORMS TO THE RULES AND REGULATIONS OF THE REGISTERS OF DEEDS OF MASSACHUSETTS.

WILLIAM S. MacLEOD
REG. PROF. ENGINEER

FOR REGISTRY USE ONLY

\\06-10\\dwg\\FLOOR.dwg

CONDOMINIUM FLOOR PLAN THE RED TAVERN CONDOMINIUM METHUEN, MASS.

Scale: 1"=6' Date: November 14, 2006

PREPARED FOR: FIVE PLEASANT STREET, LLC

PREPARED BY:

andover
consultants
inc.

1 East River Place
Methuen, MA 01844

William S. MacLeod
Reg. Prof. Engineer

SHEET 3 OF 3

0 6 12 18 24 Ft.

